


DISTANCES		
	Dist.	Total Dis.
G.S.L. City	13 1/2	13 1/2
Point of Mountain	12 1/2	26 1/2
Youngs Mill	8 1/2	35
Poeble City	6 1/2	41 1/2
Stockton	11 1/2	53
Center	10	63
Faust's (Rush Valley)	8 1/2	71 1/2
Point Lookout	16 1/2	88
Simpsons Spring	8	96
River-Bed	10 1/2	106 1/2
Dug-Way	14 1/2	121
Black Rock	9 1/2	130 1/2
Fish Springs	12	142 1/2
Boyd's	9 1/2	152 1/2
Willow Springs	12	164 1/2
Canyon Station	15	179 1/2
Deep Creek	7	186 1/2
Eight-Mile	19 1/2	206 1/2
Antelope Spring	13 1/2	220 1/2
Spring Valley	10 1/2	231 1/2
Schell Creek	15 1/2	247 1/2
Egan Canyon	13 1/2	261 1/2
Butte	15 1/2	277 1/2
Mountain Springs	9 1/2	286 1/2
Ruby Valley	13 1/2	300 1/2
Jacks Well	10	310 1/2
Diamond Springs	12 1/2	323 1/2
Sulphur Springs	14 1/2	338 1/2
Roberts Creek	13 1/2	352 1/2
Grubb's Well	13	365 1/2
Dry Creek (Crossing)	10 1/2	376 1/2
Cape Horn	14 1/2	391

EXPLANATION: The double dotted line shows the position of Overland Mail road, and the red line shows the old telegraph line, wherever either varies from the new telegraph line. The heavy black line shows the new line of telegraph; \* Telegraph Stations; ■, Home Stations; and the cross marks, thus — [—] — testing places.

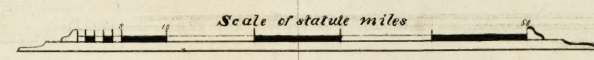

# MAP

OF THE

## California State Telegraph

AND

### OVERLAND MAIL ROAD

Austin to Great Salt Lake City.

FROM ACTUAL SURVEY AUG, 1866.

Drawn by E. W. WELTON